




FOUNDATION PLAN
1:1

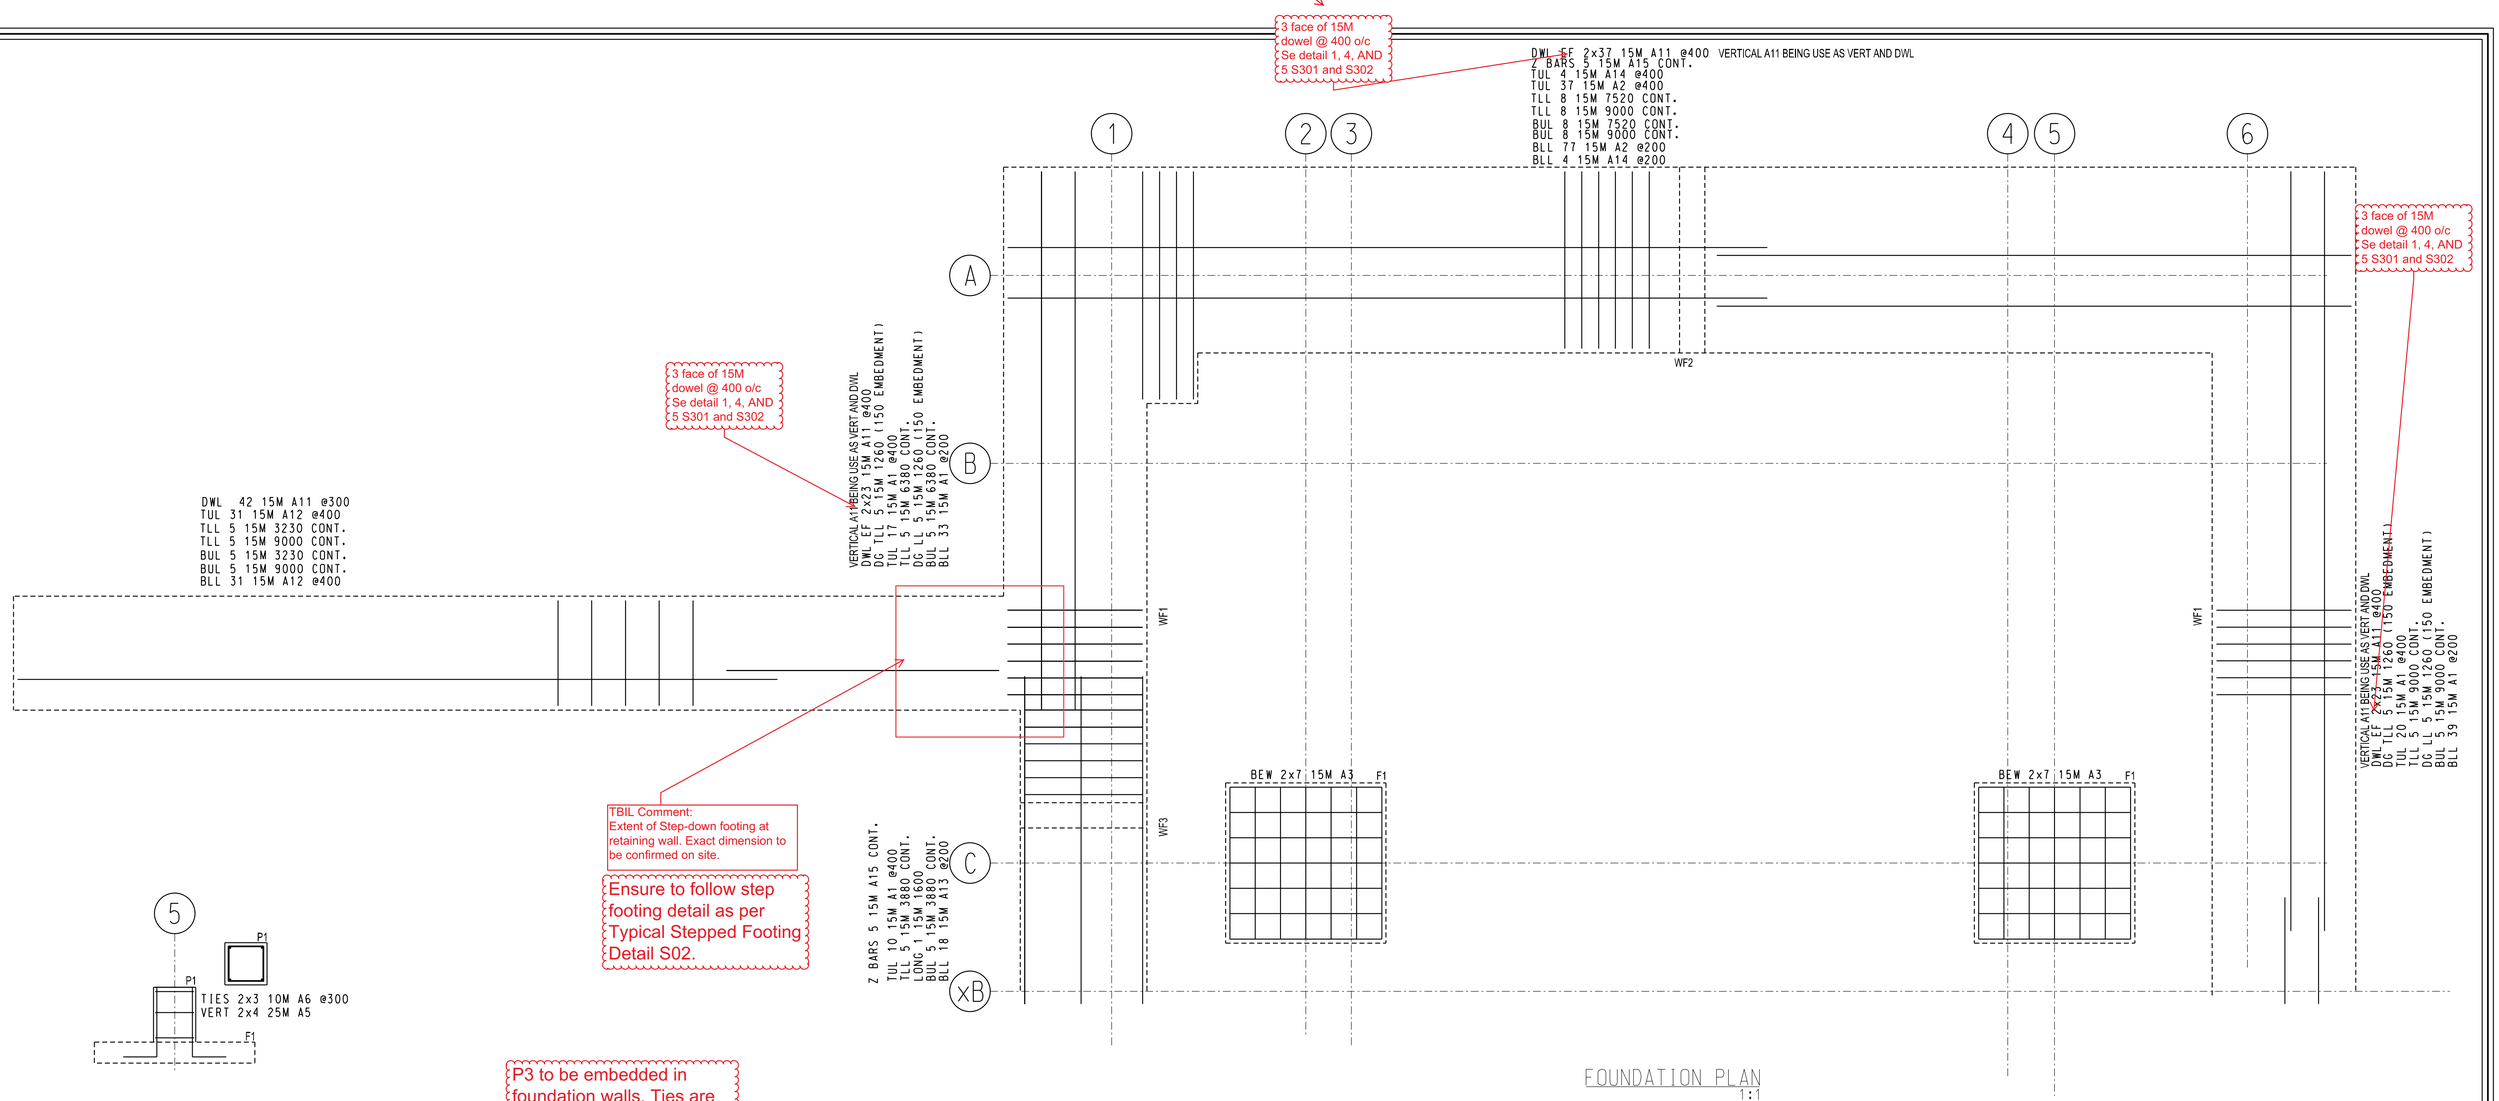

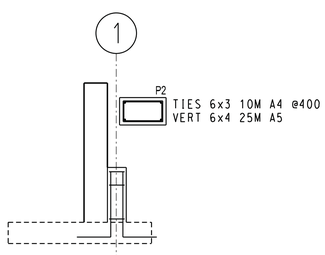

P3 to be embedded in foundation walls. Ties are not required

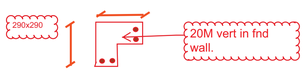

QTY	SIZE	EP	BAR MARK	V	BND TYP	CD	A	B	C	D	E	F/R	G	H	J	K	O
32	25M		A5		2		400	775									
8	20M		A8		2		310	775									
119	15M		A1		1		180	1600					180		134		
114	15M		A2		1		180	2100					180		134		
28	15M		A3		2		260	1800					260				
208	15M		A11		2		260	775									
62	15M		A12		1		180	1250					180		134		
18	15M		A13		1		180	1400					180		134		
8	15M		A14		1		180	2700					180		134		
10	15M		A15		6			600	462	600				250		388	
18	10M		A4		T2		100	470	245	470	245		100				
6	10M		A6		T2		100	420	420	420	420		100				
36	15M						9000										
16	15M						7520										
10	15M						6380										
10	15M						3880										
10	15M						3230										
1	15M						1600										
20	15M						1260										

REVIEWED
By Pat Sample at 3:04 pm, Nov 07, 2018

SHOP DRAWING REVIEW
REVIEWED ☑
REVISED AS NOTED ☐
REVISE AND RESUBMIT ☐

"This review is for the sole purpose of ascertaining conformance with the general design concept for architectural features only, and does not in any way constitute review of the design of engineering elements which form part of the Contract Documents prepared by others. This review shall not mean that the Architect approves the detail design inherent in the shop drawings. This responsibility shall remain with the Contractor submitting same, and such review shall not relieve the Contractor of his responsibility for errors or omissions in the shop drawings or of his responsibility for meeting all requirements of the Contract Documents. The Contractor is responsible for dimensions to be confirmed and correlated at the job site, for information that pertains solely to fabrication processes, or to techniques of construction and installation and for co-ordination for the work of all trades."

By: Jane Q Sample Date: Nov. 13, 2018
HOBIN ARCHITECTURE INCORPORATED

HOBIN ARCHITECTURE

SHOP DRAWING REVIEW
CUNLIFFE & ASSOCIATES

This review is for the sole purpose of determining general conformance with the Structural Drawings. This review does not mean that Cunliffe & Associates approves the detail design inherent in the shop drawings. The responsibility for which remains with the Contractor submitting the shop drawings. Our review does not relieve the contractor of his responsibility for errors or omissions in the shop drawings or meeting the requirements of the Contract Documents. The Contractor is responsible for dimensions to be confirmed and correlated at the job site and information that pertains solely to fabrication processes or to techniques of construction installation and for co-ordination of the work of all subtrades.

☒ REVIEWED AS NOTED
☐ REVIEWED
☐ RESUBMIT

CHK'D BY JD
DATE 11/13/18

DETAILING NOTES
GRADE 400 W

CONCRETE STRENGTHS

FOUNDATION WALL	25MPa
FOOTING	25 MPa
SLAB ON GRADE	25 MPa
RETAINING WALL	31 MPa

CONCRETE COVERS

FOOTING (SIDE)	50mm
FOOTING BOTTOM	75mm
WALLS	50mm
COLUMNS	40mm

CLASS B TENSIONS LAP

XX MPA	TOP BARS	OTHERS
10M	-	-
15M	600	-
20M	750	-
25M	-	-
30M	-	-
35M	-	-

XX MPA	TOP BARS	OTHERS
10M	-	-
15M	-	-
20M	-	-
25M	-	-
30M	-	-
35M	-	-

LEGEND

ADD	ADDITIONAL
B	BOTTOM
BB	BOND BEAM
BF	BACK FACE
CB	CORNER BAR
D&G	DRILL & GROUT
DWL	DOWELS
EE	EACH END
EF	EACH FACE
EQ	EQUALLY
ES	EACH SIDE
EW	EACH WAY
FF	FRONT FACE
GLV	GALVANIZED
H	HORIZONTAL
IF	INSIDE FACE
LL	LOWER LAYER
M	MIDDLE
MAS	MASONRY
OF	OUTSIDE FACE
STGR	STAGGERED
STN	STAINLESS
T	TOP
UL	UPPER LAYER
V	VERTICAL

REV	REMARKS	DATE	BY
3	SUBMITTED FOR REVIEW	6-NOV-18	J.DOE
2	REVEIW AS NOTED AS PER CUNLIFE & ASSOCIATES	9-OCTOBER-18	J.DOE
1	SUBMITTED FOR REVIEW	1-OCTOBER-18	J.DOE

PROJECT
TURNBULL SCHOOL MUSIC ROOM ADDITION


BY
TAL-CO BUILDING INNOVATIONS LTD


DRAWING TITLE
FOOTING


AGF STEEL - OTTAWA
3419 Hawthorne Rd.
Ottawa Ontario K1G 4G2
WWW.AGFSTEEL.COM
613-736-1500 Ext. 7097
detailer@example.com

AGF OTTAWA


DETAILED BY J.DOE
SCALE NTS
CONTRACT NO. CP9667F
P1

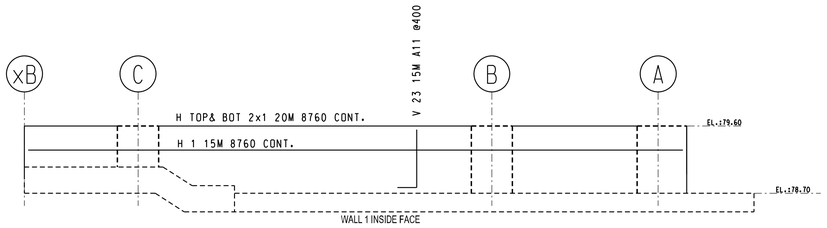


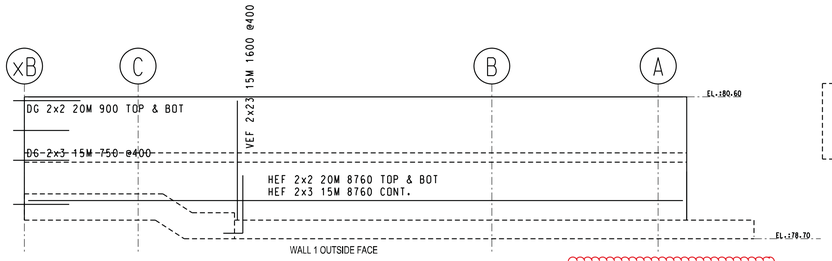

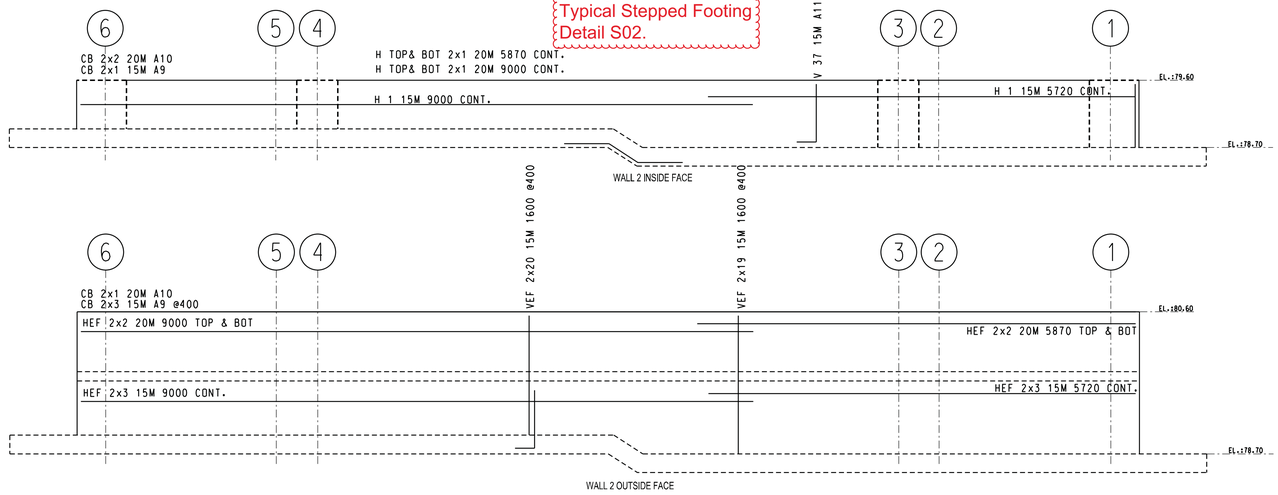


Ensure to follow step footing detail as per Typical Stepped Footing Detail S02.

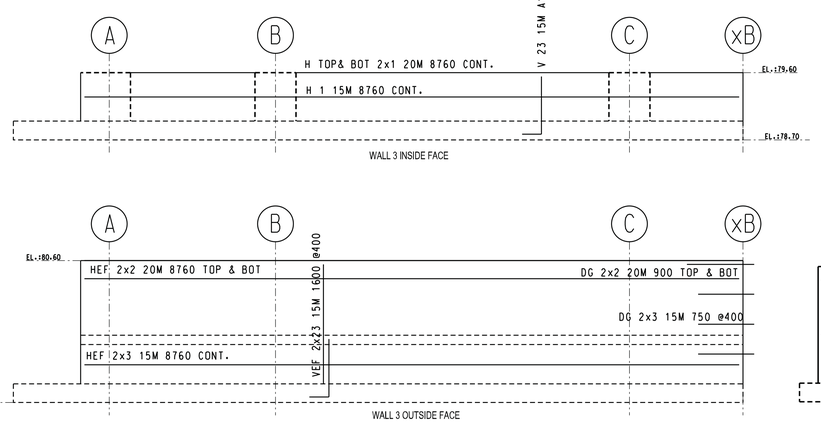


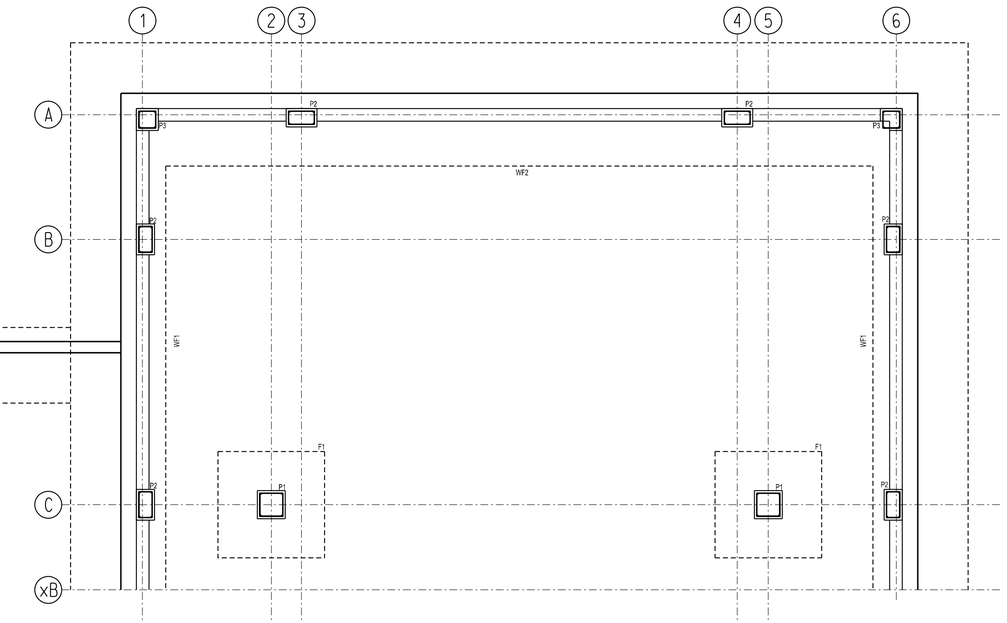

FOUNDATION PLAN
1 : 1

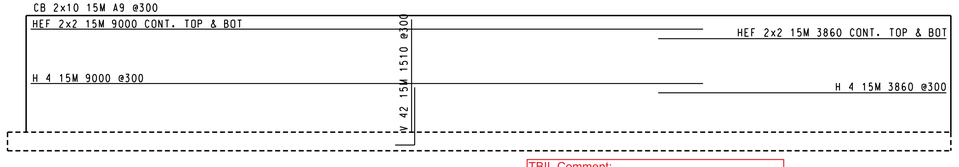

TBIL Comment:
Step Down footing at Grid 1 side due to site services interference.

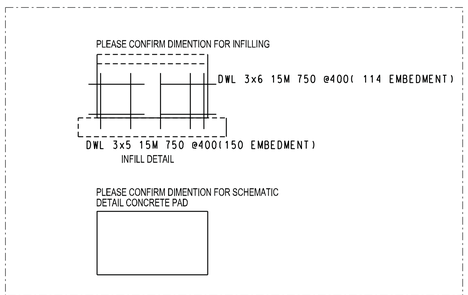

SHOP DRAWING REVIEW
REVIEWED ☑
REVIEWED AS NOTED ☐
REVISE AND RESUBMIT ☐

HOBIN ARCHITECTURE

"This review is for the sole purpose of ascertaining conformance with the general design concept for architectural features only, and does not in any way constitute review of the design of engineering elements which form part of the Contract Documents prepared by others. This review shall not mean that the Architect approves the detail design inherent in the shop drawings. This responsibility shall remain with the Contractor submitting same, and such review shall not relieve the Contractor of his responsibility for errors or omissions in the shop drawings or of his responsibility for meeting all requirements of the Contract Documents. The Contractor is responsible for dimensions to be confirmed and correlated at the job site, for information that pertains solely to fabrication processes, or to techniques of construction and installation and for co-ordination for the work of all trades."

By: Jane Q Sample Date: Nov. 13, 2018
HOBIN ARCHITECTURE INCORPORATED


SHOP DRAWING REVIEW
CUNLIFFE & ASSOCIATES

This review is for the sole purpose of determining general conformance with the Structural Drawings. This review does not mean that Cunliffe & Associates approves the detail design inherent in the shop drawings. The responsibility for which remains with the Contractor submitting the shop drawings. Our review does not relieve the contractor of his responsibility for errors or omissions in the shop drawings or meeting the requirements of the Contract Documents. The Contractor is responsible for dimensions to be confirmed and correlated at the job site and information that pertains solely to fabrication processes or to techniques of construction installation and for co-ordination of the work of all subtrades.

☒ REVIEWED AS NOTED
☐ REVIEWED
☐ RESUBMIT

CHK'D BY JD
DATE 11/13/18

REVIEWED
By Pat Sample at 3:09 pm, Nov 07, 2018

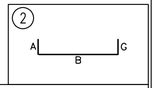

QTY	SIZE	EP	BAR MARK	V	BND TYP	CD	A	B	C	D	BENDING DIMENSIONS E	F/R	G	H	J	K	O
6	20M		A10		2		750	750									
28	15M		A9		2		600	600									
83	15M		A11		2		260	775									
6	20M						9000										
12	20M						8760										
6	20M						5870										
8	20M						900										
15	15M						9000										
14	15M						8760										
7	15M						5720										
8	15M						3860										
170	15M						1600										
42	15M						1510										
45	15M						750										

DETAILING NOTES
GRADE 400 W

CONCRETE STRENGTHS

FOUNDATION WALL	25MPa
FOOTING	25MPa
SLAB ON GRADE	25MPa
RETAINING WALL	31MPa

CONCRETE COVERS

FOOTING (SIDE & TOP)	50mm
FOOTING BOTTOM	75mm
WALLS	50mm
COLUMNS	40mm

CLASS B TENSIONS LAP

XX MPA	TOP BARS	OTHERS
10M	-	-
15M	600	-
20M	750	-
25M	-	-
30M	-	-
35M	-	-

CLASS B TENSIONS LAP

XX MPA	TOP BARS	OTHERS
10M	-	-
15M	-	-
20M	-	-
25M	-	-
30M	-	-
35M	-	-

LEGEND

ADD	ADDITIONAL
B	BOTTOM
BB	BOND BEAM
BF	BACK FACE
CB	CORNER BAR
D&G	DRILL & GROUT
DWL	DOWELS
EE	EACH END
EF	EACH FACE
EQ	EQUALLY
ES	EACH SIDE
EW	EACH WAY
FF	FRONT FACE
GLV	GALVANIZED
H	HORIZONTAL
IF	INSIDE FACE
LL	LOWER LAYER
M	MIDDLE
MAS	MASONRY
OF	OUTSIDE FACE
STGR	STAGGERED
STN	STAINLESS
T	TOP
UL	UPPER LAYER
V	VERTICAL

REV	REMARKS	DATE	BY
3	SUBMITTED FOR REVIEW	6-NOV-18	J.DOE
2	REVIEW AS NOTED AS PER CUNLIFE & ASSOCIATES	9-OCTOBER-18	J.DOE
1	SUBMITTED FOR REVIEW	1-OCTOBER-18	J.DOE

PROJECT
TURNBULL SCHOOL MUSIC ROOM ADDITION

BY
TAL-CO BUILDING INNOVATIONS LTD.

DRAWING TITLE
FOUNDATION

AGF STEEL - OTTAWA
3419 Hawthorne Rd.
Ottawa Ontario K1G 4G2
WWW.AGFSTEEL.COM
613-736-1500 ExEt. 7097
detailer@example.com

AGF OTTAWA

DETAILED BY J.DOE
SCALE NTS
CONTRACT NO. CP9667F
P2